



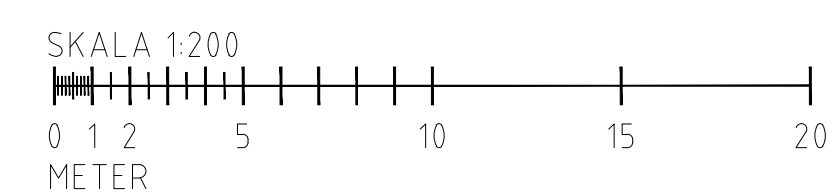

SKALA 1:200 (A1) 0 10 20

100% MÅTTRIKTIGHET KAN EJ GARANTERAS.
MÅTT BÖR DÄRMED KONTROLLERAS INNAN
RITNINGEN ANVÄNDS SOM UNDERLAG.

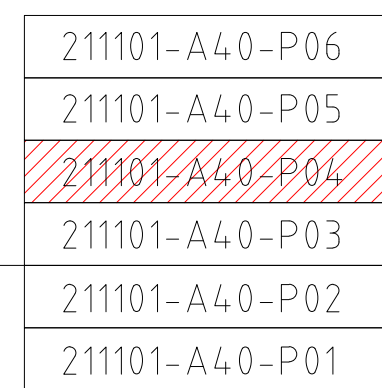

G	-	RUM 208	A	2023-03-27
F	-	RUM 207.01	A	2022-03-11
E	-	207.08	A	2021-11-01
D	-	REV. BUTH 295, 296	A	2021-10-22
C	-	REV. BUTH 295, 296, 297 & 299	A	2021-10-06
B	-	ANDRÉAN DUAN ENTRE CIL, LINDERLAG	A	2020-05-09
A	-	PMORE REVEDERGHAR	A	2020-04-13
BET	ANT	REVEDERGHEN AY-SER	SGN	DATUM

RELATIONSHANDLING				A		-		MINRE REJVERISER		A		2020-06-11	
				BET		ANT		REJVERISER A VSER		SDN		DATUM	
				FASTIGHET		2111, KV. ABBORREN 11 STORGATAN 36-38, LULEÅ							
				ADRESS									
PROJEKTNAMN OCH NUMMER --				PLAN 4		1 TR. ÖVERSIKT PLANRITNING							
													
Val: 010-33 00 323 info@fsn.se www.fsn.se													
KUNDGILT FIRE SAFETY NORDIC AB													
RETAD AV J. LÖFGREN		HANDELSÄGARE E. LINQVALL		ÅRST-TAUPPER 112/4		RITNINGNUMMER 211101-A40-1-0400							
DRT		DATUM		SKALA									
LULEÅ		2020-04-13		A1 1:200 A3									
				RITNINGNUMMER		BET							
						BLAD							

21101-44.0-1-04.00 DWG	IONATHAN I. OGBURN
------------------------	--------------------